

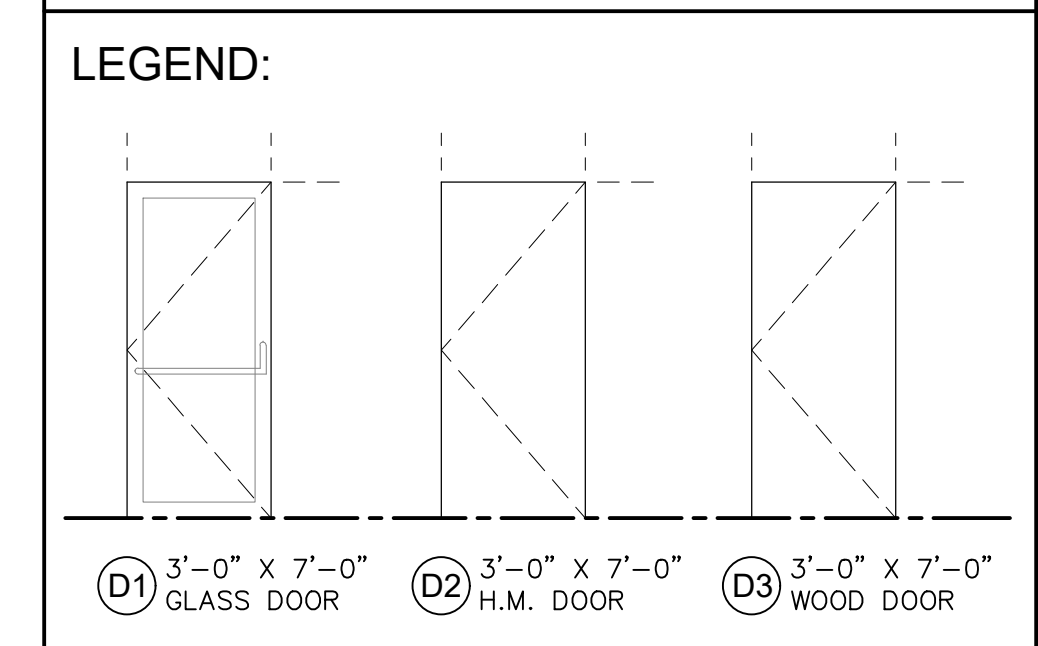


GENERAL NOTES:
 1. CONTRACTOR TO FIELD VERIFY ALL EXISTING CONDITIONS AND NOTIFY ARCHITECT OF ANY DISCREPANCY, P.T.C.

LEGEND:
 — EXTERIOR WALL: MASONRY TILT WALL PANEL
 - - - EXISTING DEMISING WALL - 1HR RATED PARTITION: 6" METAL STUDS w/ 5/8" GYP. BOARD BOTH SIDES
ROOM ROOM NAME, ROOM NUMBER, FLOOR FINISH
 [100] WOOD
 (01) 360 PHOTO POINT

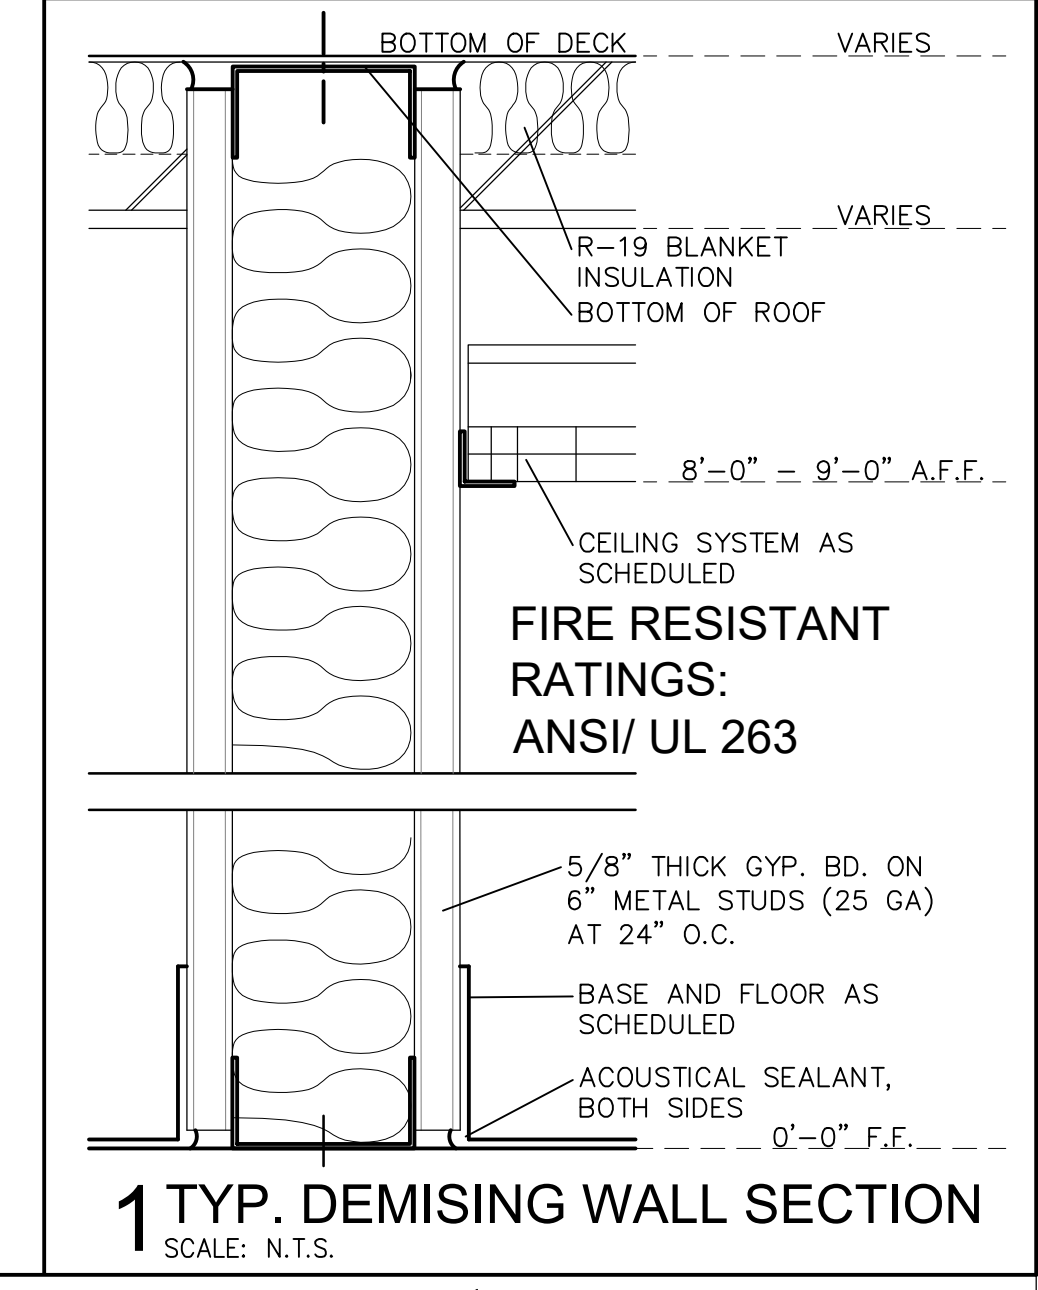

KEY NOTES:
 (1) EXISTING DEMISING WALL
 (2) EXISTING MASONRY TILT PANEL
 (3) CONCRETE STAIRS
 (4) CONCRETE RAMP
 (5) OVERHEAD DOOR (10' WIDE X 10' HIGH)
 (6) FIRE SUPPRESSION SYSTEM
 (7) ELECTRICAL PANEL
 (8) PHONE BOARD

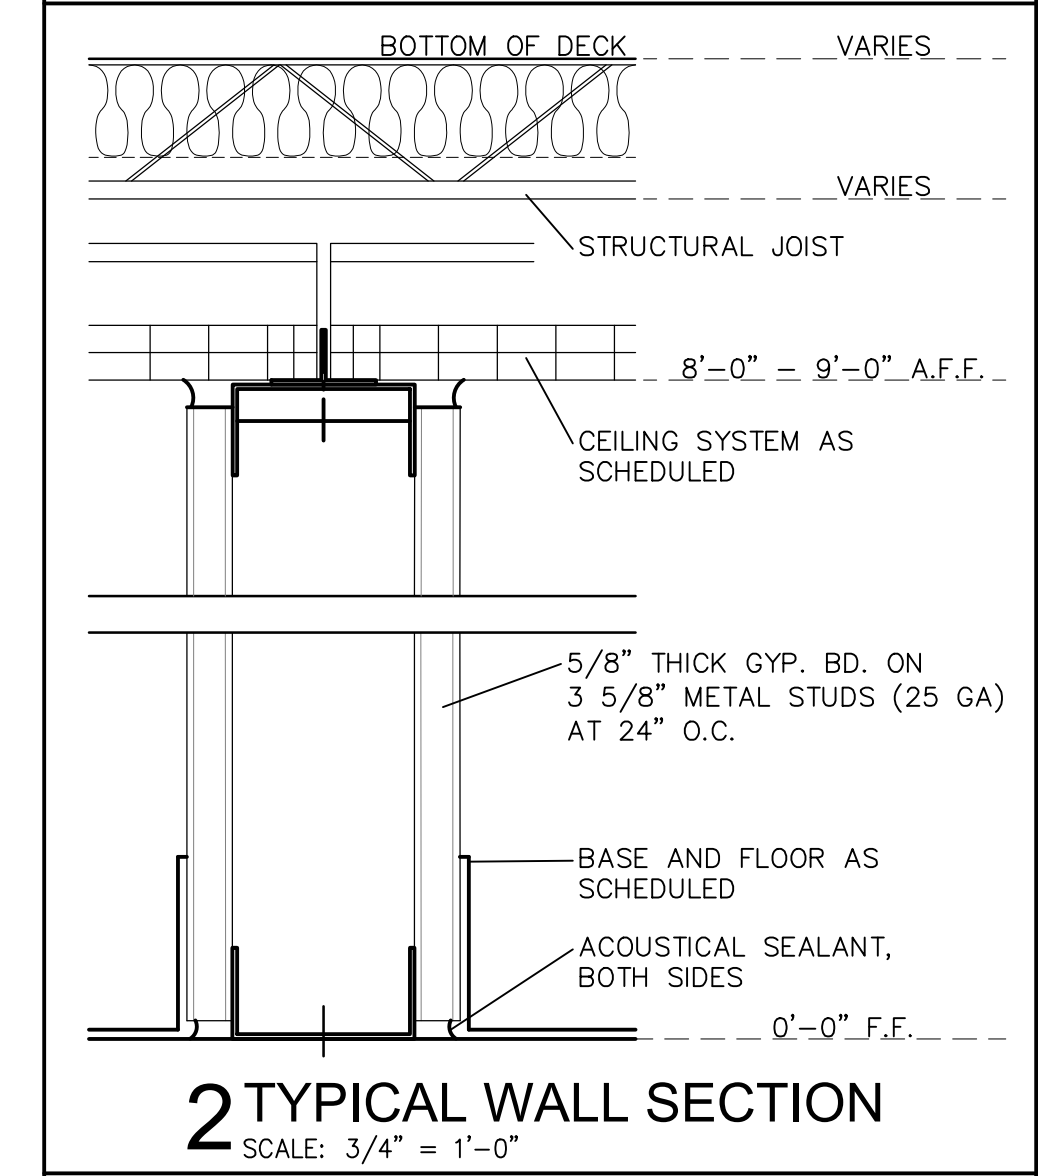

ACS architecture | asbuilts
 multifamily hospitality industrial commercial
 1322 Space Park Drive
 Suite B-122
 Houston • Texas 77058
 info@acs-architecture.com
 281.767. 9000 voice
 Firm Registration No. BR2307

STONEMASTER PROPERTIES
 ACS.2020.0722
 417 SUNBELT DRIVE
 CORPUS CHRISTI, TEXAS 78408

© ACS architecture | asbuilts
 2020 ACS ARCHITECTURE, LLC DOCUMENTS AND INSTRUMENTS OF SERVICE ARE GIVEN IN CONFIDENCE AND REMAIN THE PROPERTY OF ACS ARCHITECTURE, LLC. THIS DOCUMENT AND THE INFORMATION CONTAINED HEREIN MAY NOT BE DUPLICATED, USED, OR DISCLOSED WITHOUT WRITTEN CONSENT OF ACS ARCHITECTURE, LLC. THIS IS AN UNPUBLISHED SURVEY DOCUMENT OFFERED BY ACS ARCHITECTURE, LLC. IT IS SUBMITTED FOR YOUR PERSONAL USE IN CONNECTION WITH THE CONTRACTED PROJECT PERFORMED BY ACS ARCHITECTURE, LLC. ALL OR ANY PART OF THE SURVEY DOCUMENT (EXCEPTING REGISTERED TRADEMARKS) REMAINS THE PROPERTY OF ACS ARCHITECTURE, LLC.

Revision Date:

Issue/Date

ASBUILTS: 07-22-2020

A2.01
 OVERALL FLOOR PLAN
 DOOR & WINDOW SCHEDULES
 PARTITION TYPES
 GENERAL INFORMATION