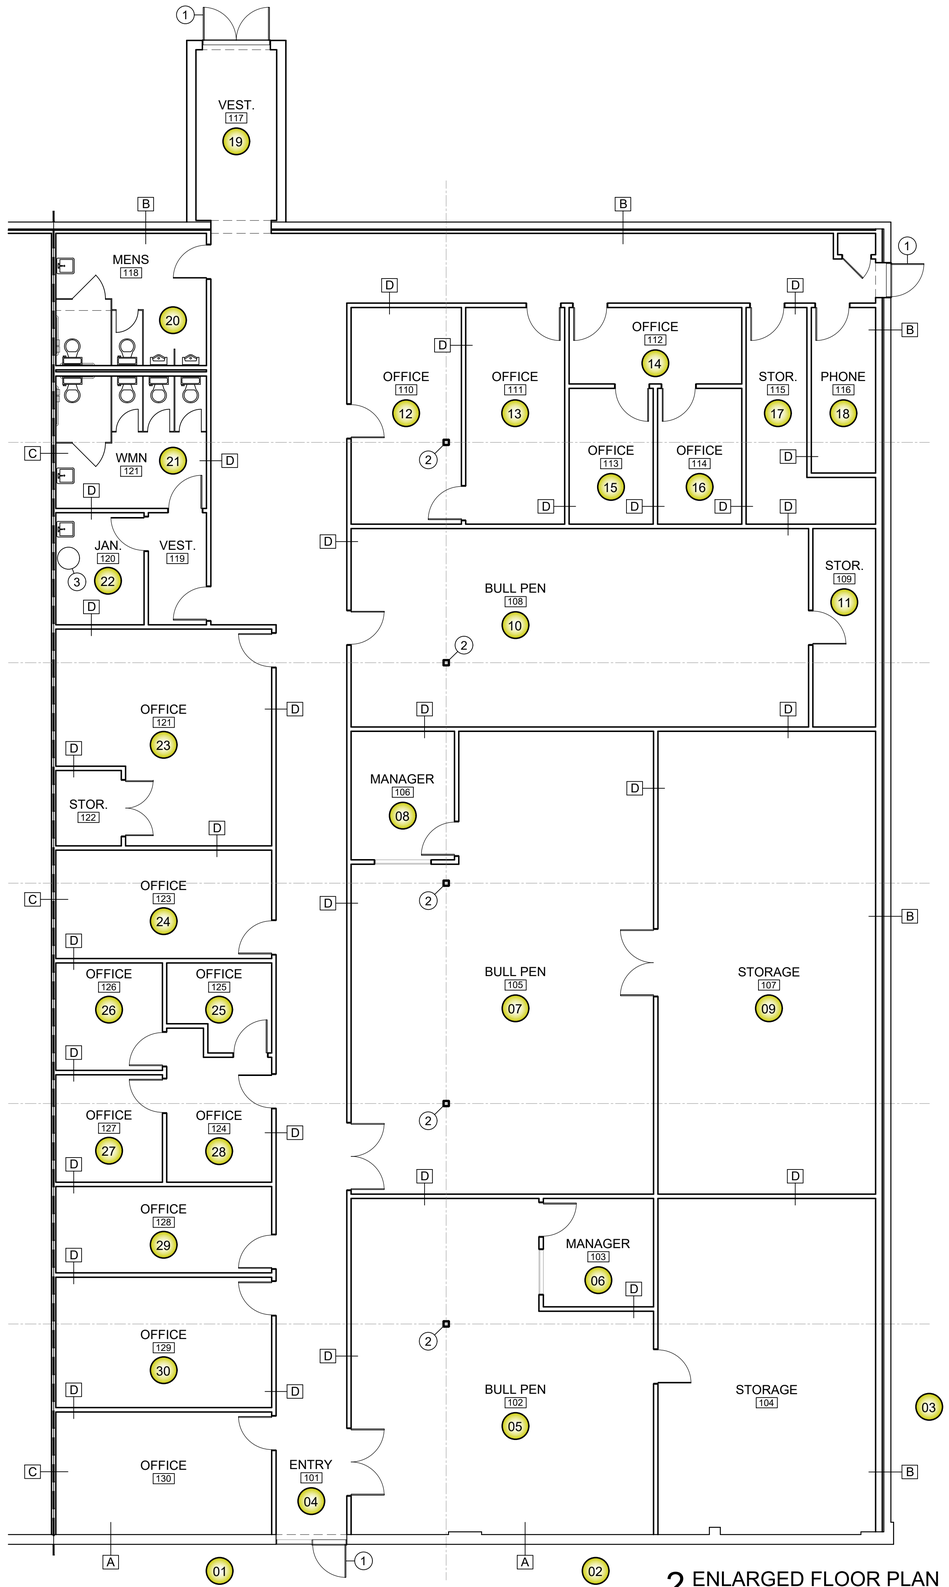

2 ENLARGED FLOOR PLAN
SCALE: 3/16" = 1'-0"

GENERAL NOTES:

1. CONTRACTOR TO FIELD VERIFY ALL EXISTING CONDITIONS AND NOTIFY ARCHITECT OF ANY DISCREPANCY PRIOR TO CONSTRUCTION.

LEGEND:

TYPE: A EXTERIOR WALL – MASONRY BRICK OVER CMU BLOCK W/ 5 1/2" WOOD STUDS W/ 3/8" PLYWOOD

TYPE: B EXTERIOR WALL – CMU BLOCK W/ 5 1/2"WOOD STUDS W/ 3/8" PLYWOOD

TYPE: C 1 HOUR RATED PARTITION UL U 3 5/8" METAL STUDS w/ 5/8" GYP. BOARD BOTH SIDES TO UNDERSIDE OF DECK.

TYPE: D INTERIOR WALL – NON RATED PARTITION: 3 5/8" METAL STUDS w/ 5/8" GYP. BOARD BOTH SIDES

ROOM 100 ROOM NAME AND ROOM NUMBER

1 HOUR RATED TENANT SEPARATION WALL

01 360 PHOTO POINT

KEY NOTES:

1 EXIT DOOR

2 8" COLUMN

3 WATER HEATER

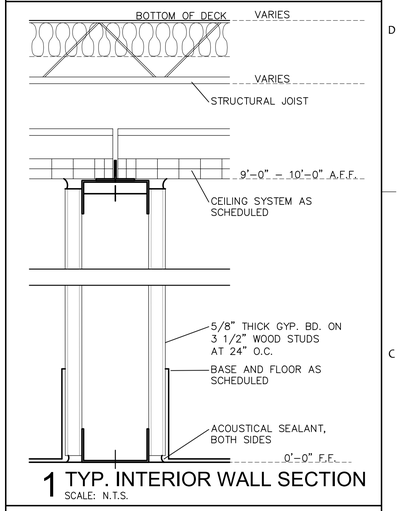

1 TYP. INTERIOR WALL SECTION
SCALE: N.T.S.

ACS architecture | asbuilts
multifamily hospitality industrial commercial
1322 Space Park Drive
Suite B-122
Houston • Texas 77058
info@acs-architecture.com
281.767. 9000 voice
Firm Registration No. BR2307

STONEWATER PROPERTIES

ACS.2020.0718

200 NORTH ST. MARY'S STREET
BEEVILLE, TX 78102

© ACS architecture | asbuilts

2020 ACS ARCHITECTURE, LLC DOCUMENTS AND INSTRUMENTS OF SERVICE ARE GIVEN IN CONFIDENCE AND REMAIN THE PROPERTY OF ACS ARCHITECTURE, LLC. THIS DOCUMENT AND THE INFORMATION CONTAINED HEREIN MAY NOT BE DUPLICATED, USED, OR DISCLOSED WITHOUT WRITTEN CONSENT OF ACS ARCHITECTURE, LLC. THIS IS AN UNPUBLISHED SURVEY DOCUMENT OFFERED BY ACS ARCHITECTURE, LLC. IT IS SUBMITTED FOR YOUR PERSONAL USE IN CONNECTION WITH THE CONTRACTED PROJECT PERFORMED BY ACS ARCHITECTURE, LLC. ALL OR ANY PART OF THE SURVEY DOCUMENT (EXCEPTING REGISTERED TRADEMARKS) REMAINS THE PROPERTY OF ACS ARCHITECTURE, LLC.

Revision Date:

Issue/Date

ASBUILTS: 07-18-2020

A2.01

OVERALL FLOOR PLAN
LEVEL 1
GENERAL INFORMATION